


LA HABRA MARKET PLACE

1921 W. IMPERIAL HIGHWAY, LA HABRA, CA 90631

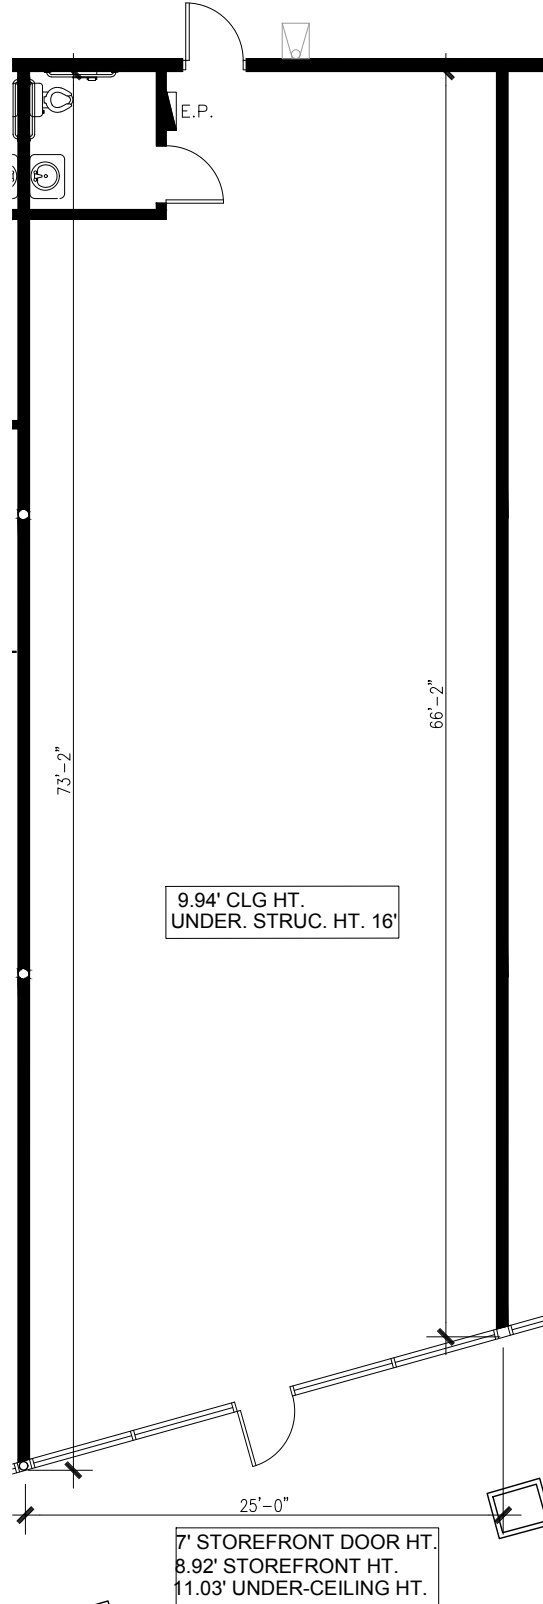

9.94' CLG HT.
UNDER. STRUC. HT. 16'

7' STOREFRONT DOOR HT.
8.92' STOREFRONT HT.
11.03' UNDER-CEILING HT.

APPROX. ASBUILT
SUITE 21-28, UNIT B
1,764 S.F.



CAPITAL PARTNERS, INC.
TEL: (714) 897-0015

MARCH 11, 2016

DJM Capital Partners, Inc. and Cadtronics, Inc. does not warrant that the information contained herein represents "As-Built" or existing field conditions. The Lease Outline Drawing is provided for reference purposes only. All information and conditions must be field verified by Tenant's architect and contractor.



CADTRONICS
(949) 251-1710