


# BELLA TERRA

7777 EDINGER AVE., SUITE 174, HUNTINGTON BEACH, CALIFORNIA

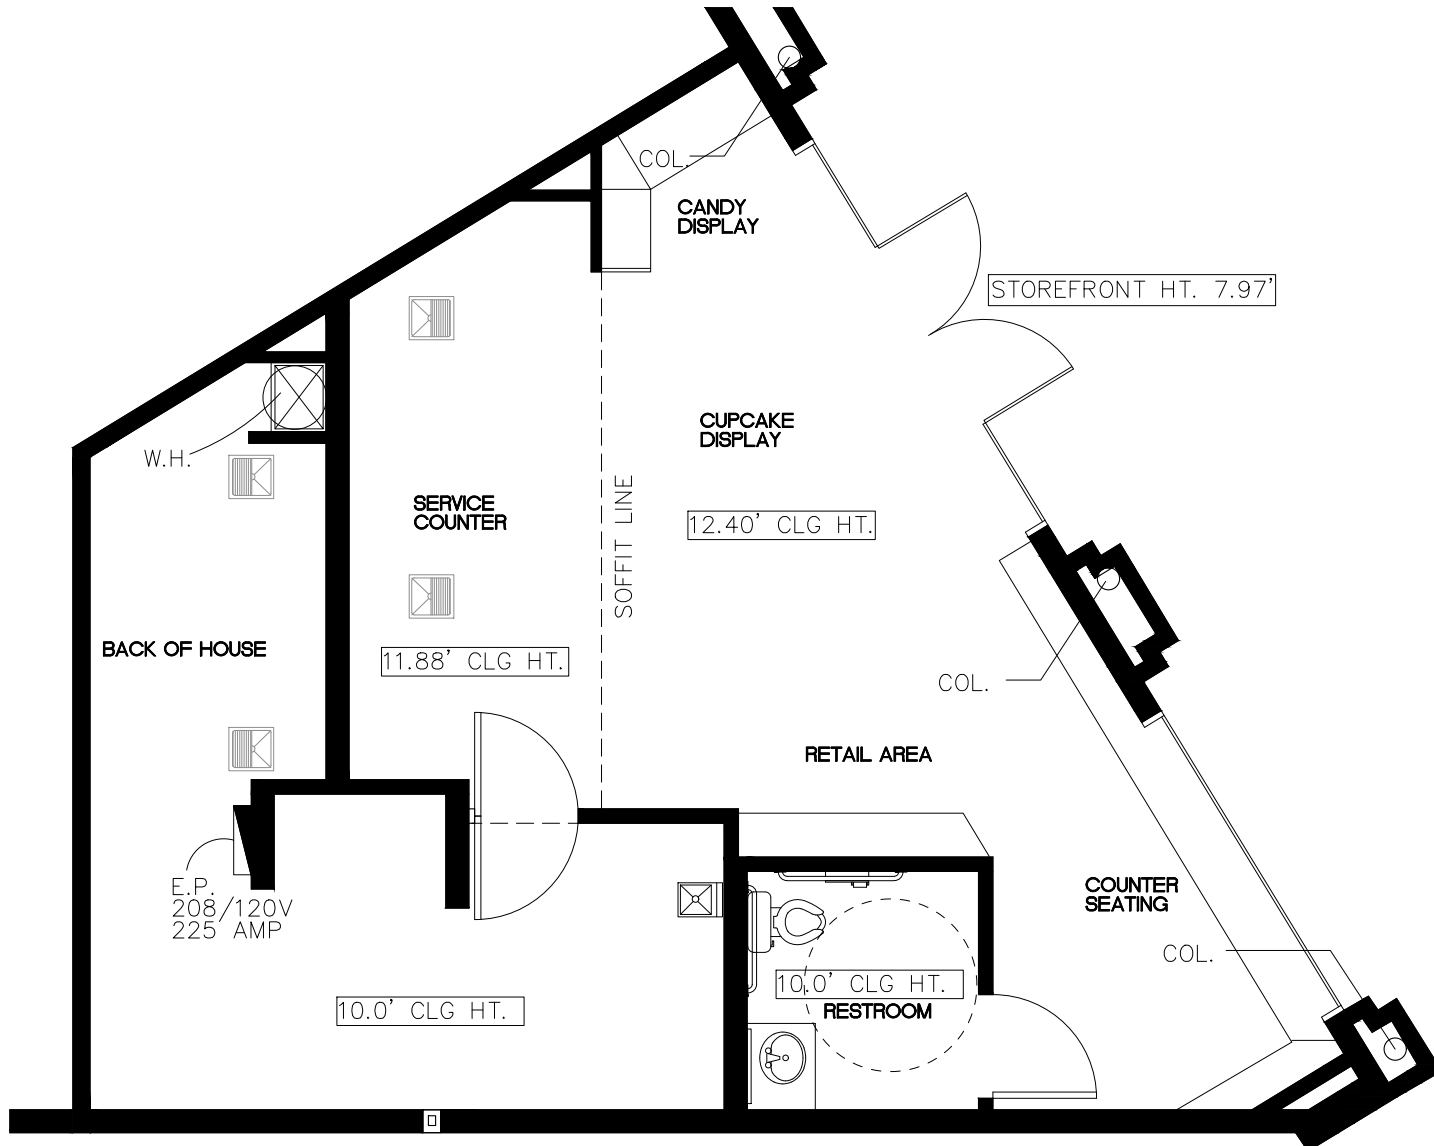

AS-BUILT




DJM

CAPITAL PARTNERS, INC.

TEL: (714) 897-0015

MARCH 31, 2017

DJM Capital Partners, Inc. and Cadtronics, Inc. does not warrant that the information contained herein represents "As-Built" or existing field conditions. The Lease Outline Drawing is provided for reference purposes only. All information and conditions must be field verified by Tenant's architect and contractor.

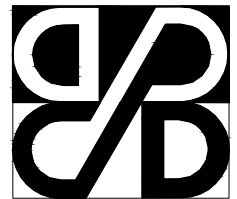

CADTRONICS

(949) 251-1710